

TOWNSHIP 20N RANGE 12W
SECTION 3


BOOK 254
MAP 11

SILVER SPRINGS
Rec. Oct. 27, 1960 98320

Code 0300

OLD BOOK 202
MAP 42

10/31/2008ck
VOID
SEE GIS

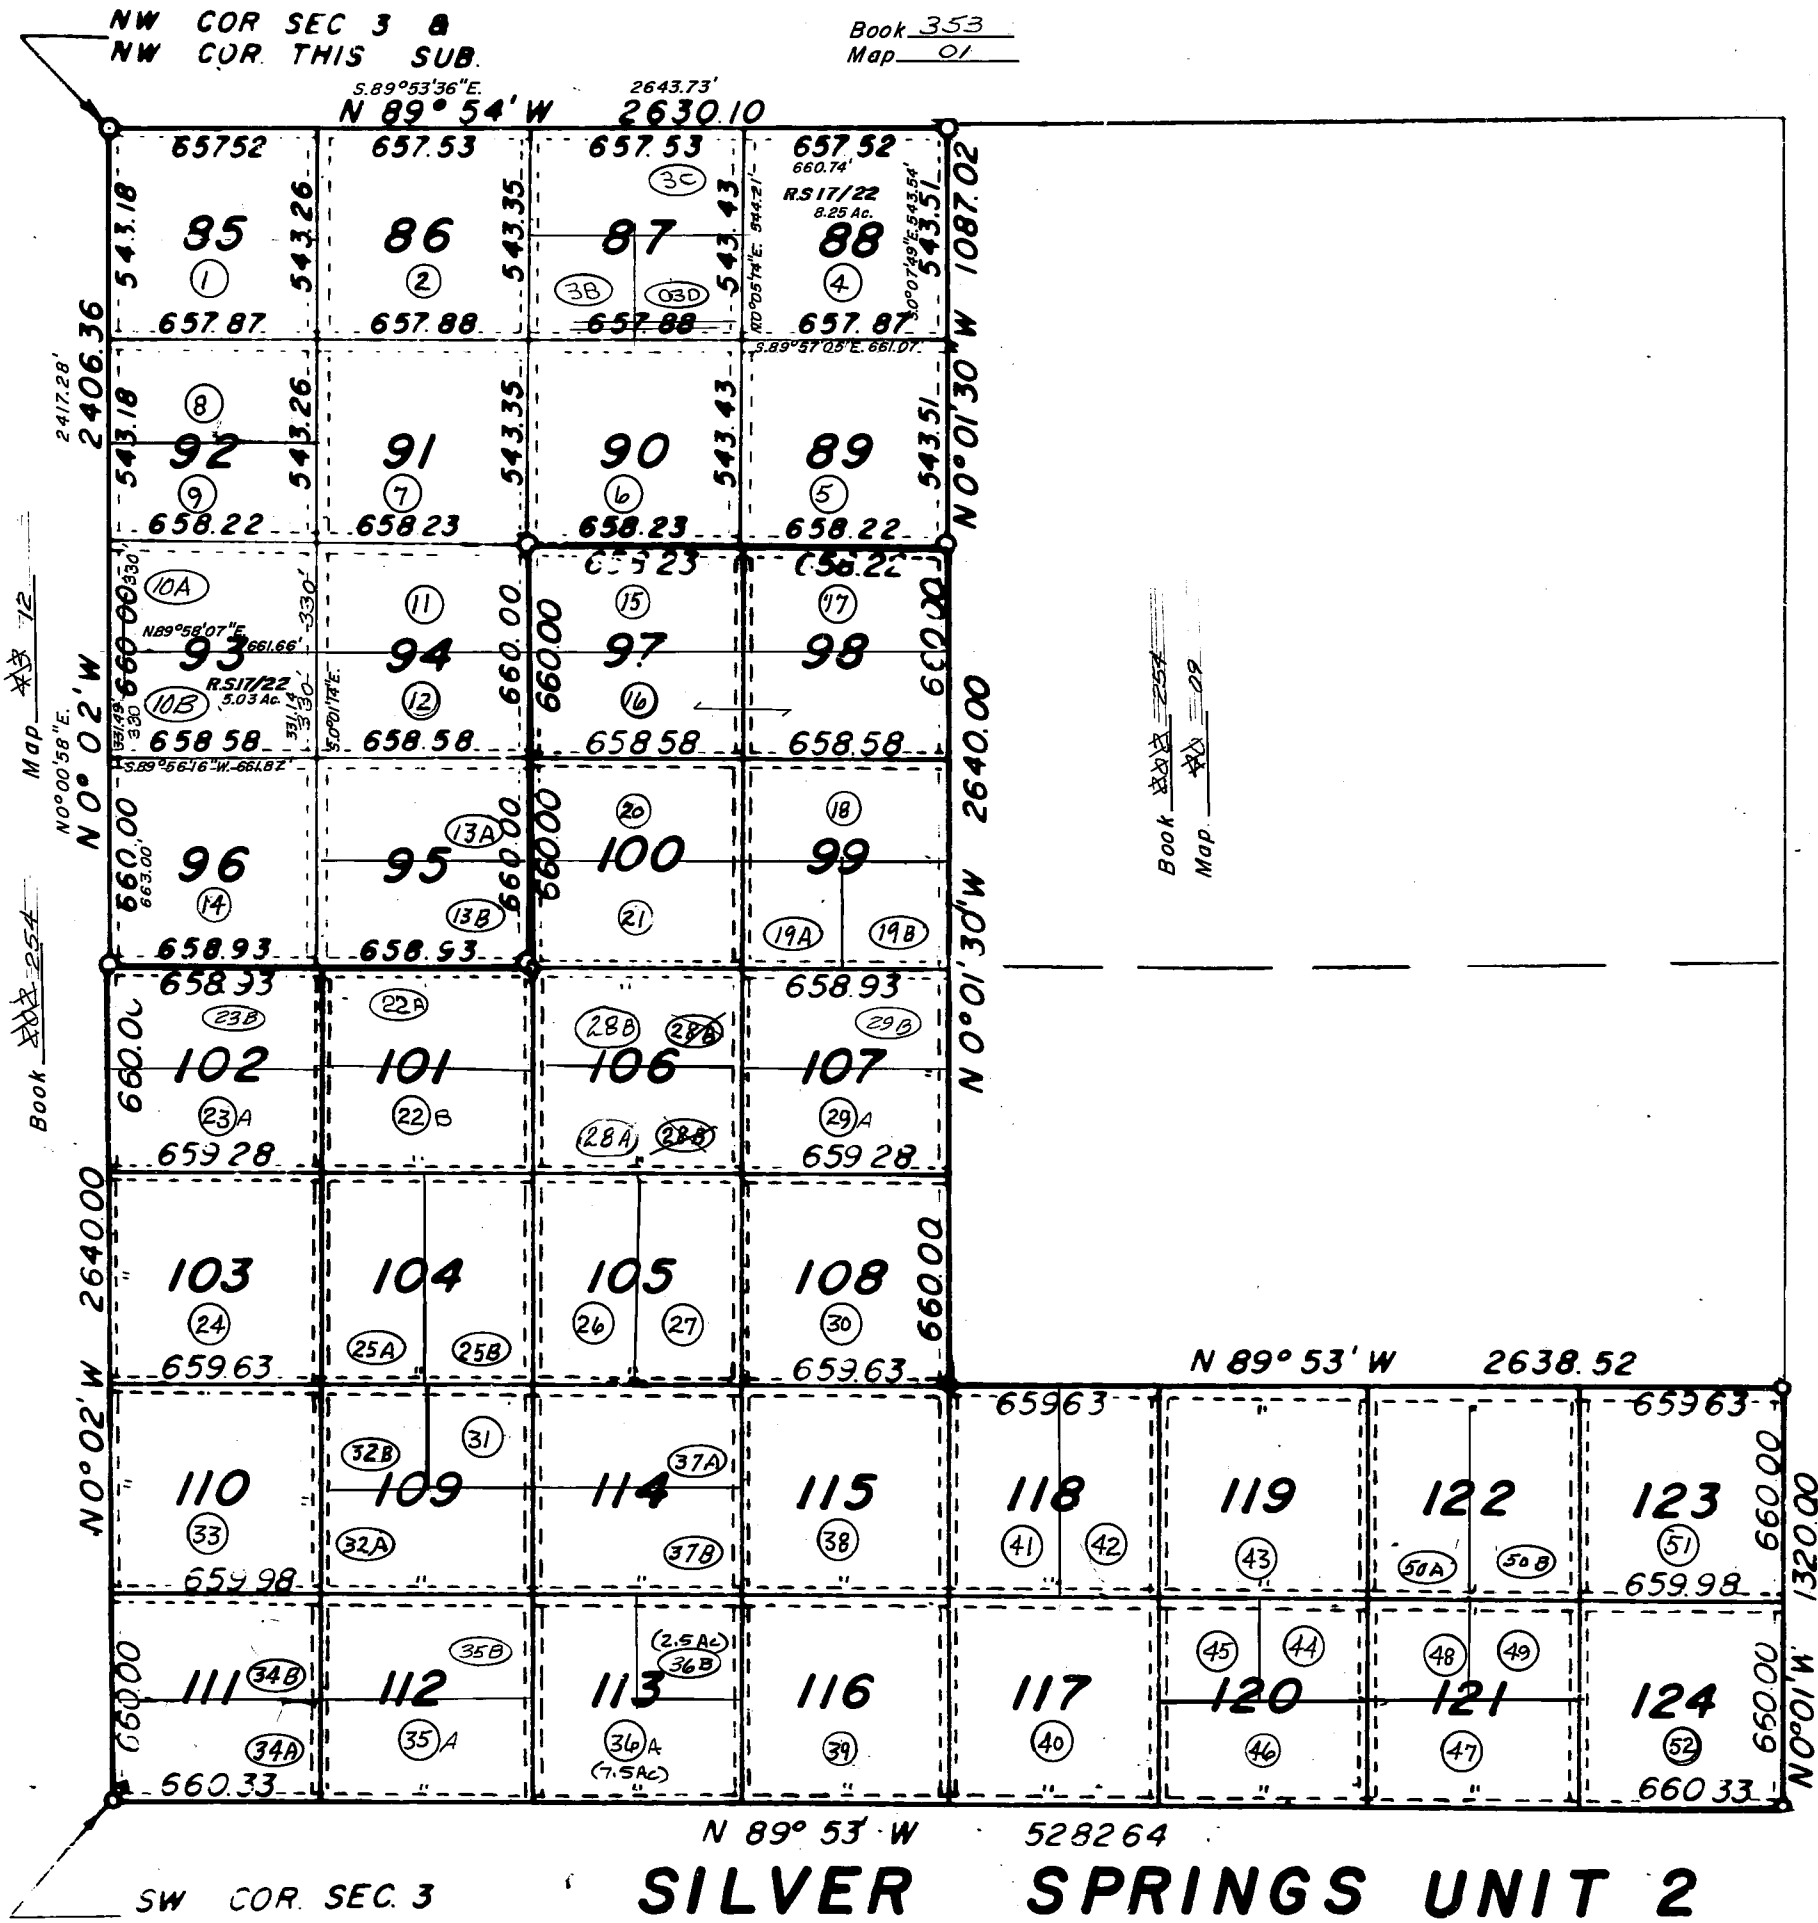

PLAT LOCATION-	REC. DATE FEE No.
R.S. 17/22 PAR. 88 & 31/2 93	10/30/1998 98-65729



SCALE 1" = 600'

SE COR.
SEC. 3

SILVER SPRINGS UNIT 2

Rec. Feb. 7, 1961 100BB3
Book ~~254~~
Map ~~11~~

20N-12W-3
Date DEC. 28, 2004

MOHAVE COUNTY ASSESSOR